
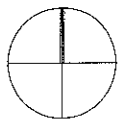


N:\Project Files\Projects\99-00-01-02\366-00 Ball Road Business Park\366-01 As Built - 741 E Ball Rd - Gr Floor - Suite 105, 11/28/2007 9:13:36 AM

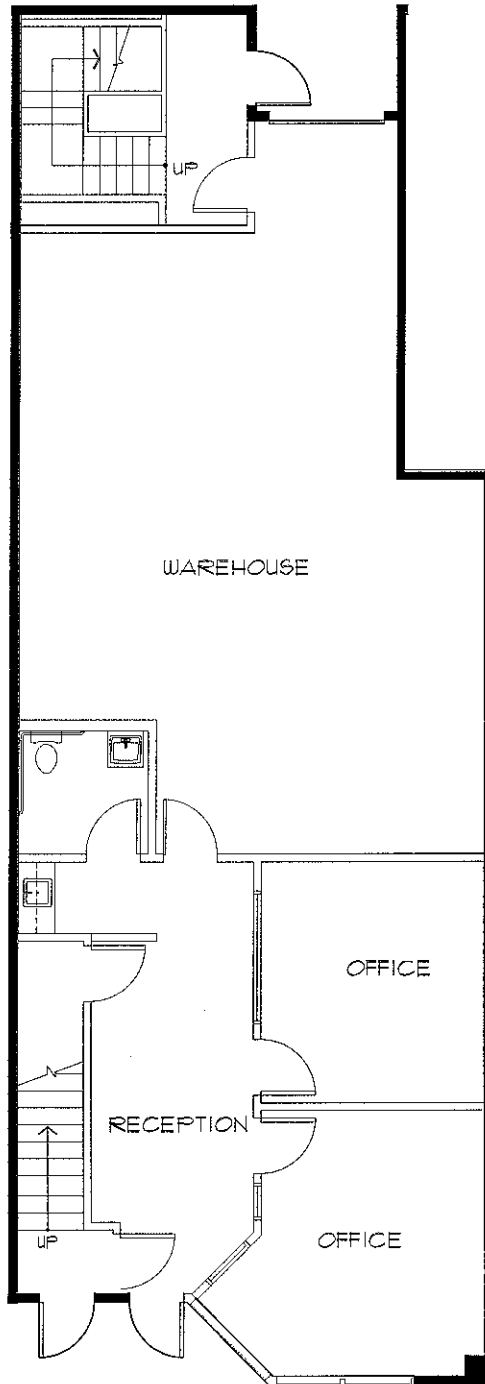

NORTH

SCALE: 3/32" = 1'-0"

CDL Associates, Inc.

INTERIOR ARCHITECTURE & SPACE PLANNING

26012 Meritt Circle, Suite 124
Laguna Hills, CA 92653
(949) 367-1123 • Fax (949) 367-1190
E-mail: CDL@cdlassociatesinc.com

SUITE 105

BALL ROAD BUSINESS PARK
741 EAST BALL ROAD, SUITE 105
ANAHEIM, CA
1,809 R. SQ. FT.
11/27/07

ALL ROOM SIZES ARE APPROXIMATE. ALL INFORMATION REPRESENTED ON THIS DRAWING IS BELIEVED TO BE ACCURATE.
HOWEVER, TENANT SHOULD VERIFY ALL PERTINENT INFORMATION PRIOR TO COMMITTING TO A LEASE. THIS PLAN IS NOT INTENDED FOR CONSTRUCTION PURPOSES.